

Project

KEMH BERMUDA

Notes

1. Do not scale from this drawing.

2. Site verify all dimensions and levels prior to construction.


3. Report all discrepancies to the Drawing Originator immediately.

4. This drawing to be read in conjunction with all relevant documents and drawings.

5. All General Arrangement plans taken at a cut plane of 5' unless stated otherwise.

Revisions

Rev	Date	Description	Rev/Chk
01	29.07.11	50% CD SUBMISSION	AD/DC
02	16.09.11	100% CD SUBMISSION	AD/DC
03	27.08.12	REVISIONS TO SITE PLAN	AD/DC
04	16.11.12	SITE PLAN UPDATED	AD/DC
05	11.12.12	RETAINING WALL UPDATED	AD/DC
06	15.01.13	CHAIN LINK FENCE ADDED	AD/DC
07	26.02.13	SITE PLAN UPDATED	AD/DC
08	23.05.13	SITE PLAN UPDATED	AD/DC
09	04.06.13	PAVING DETAIL UPDATED	AD/DC
10	12.06.13	PLANTING & STAIRS REVISED	AD/DC
11	12.08.13	PLANTING & PAVING REVISED	AD/DC
12	21.02.14	PLANTING & PAVING REVISED	AD/DC
13	17.03.14	LAYOUT REVISED	AD/DC
14	02.04.14	SITE PLAN UPDATED	AD/DC
15	21.04.14	GATE AREA & LAYOUT REVISED	AD/DC
16	25.04.14	FINAL ISSUE / AS BUILT	AD/DC

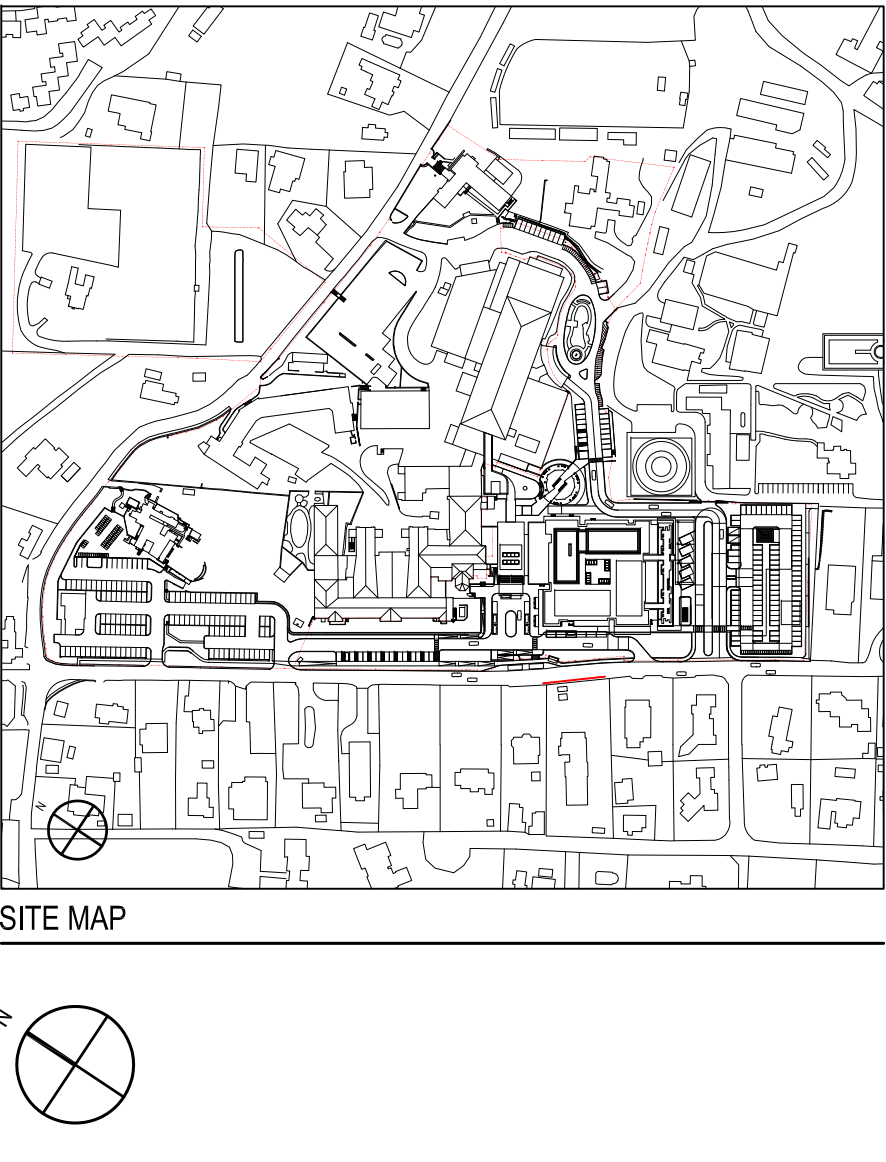

Drawn By	Drawn Date	Checked By	Checked Date
DC	06 JUL 2011	DC/DO	25 APR 2014
Scale		Drawing Status	
1" = 40'-0" @ 24"X36" size		FINAL ISSUE / AS BUILT	
Title			